BY K.L. QUINN DATE 12/29/72 SUBJECT Survey of Jno F. Moore tract for a division between him & J.C. Phillips (Phillips to have Tabbs interest) SHEET NO ____ OF ____

CHKD BY ____ DATE ____ JOB NO Survey Bk. #1 Page 170, March 21, 1877

SCALE .1" = 200'

Note:

From the edge of the Front Porch to the Back Porch is thirty-four (34') feet. The division line runs through the House.

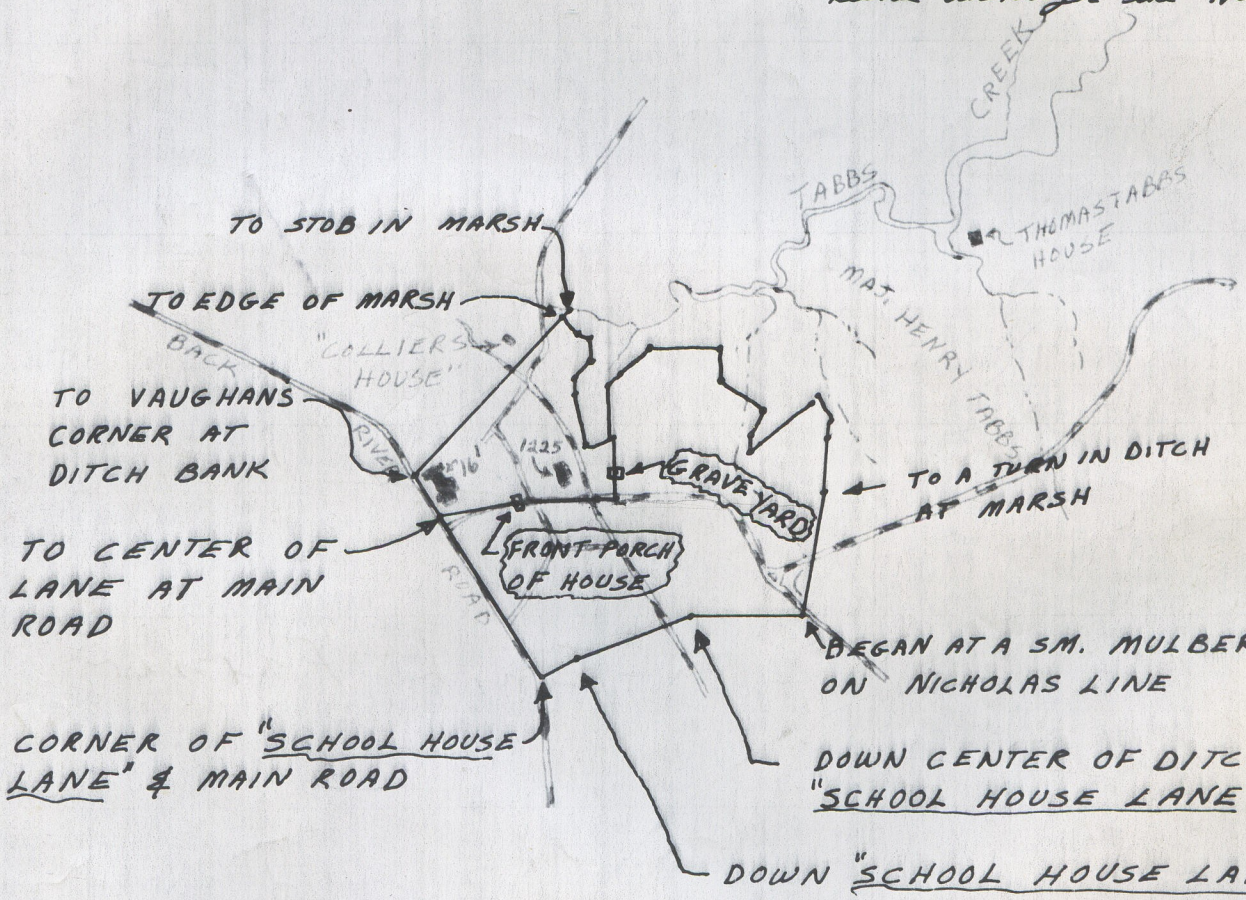

Division between John F. Moore and J. C. Phillips - Surveyed 21 May 1877
Eliz. City Co. Surveys & Plats, Book 1, page 170

At the request of Jno. F. Moore I then surveyed for a Division betw. him and J. C. Phillips the Moore Farm in Back River Phillips to have Tabb's interest. Begin at sm. mulberry stump on Nickolas' line and run along said line in cen. Ditch

1. S 8½ W 17.10 poles ~~282~~ 1129 down cen. Ditch to School House Lane
2. S 69 W 18.90 ~~312~~ 1247 " Schl. H. Lane
3. S 61¾ W 6.25 ~~103~~ 412 cen. " " " and Main Road (off. 18 to Main Rd. .18' = 12'
4. N 31½ W 30.18 ~~498~~ 1992 to Cen. lane at Main Road (N 58½ E) then up Main Rd.
   ← was 81¾ but changed recently 2458
5. " " 7.06 ~~116~~ 466 to Vaughan's Cor. at Ditch bank (offset S 48 E 45') 30' then
6. N 42 E 34.05 ~~562~~ 2247 to edge of marsh. Sa. Co. 1.40 to stob in marsh
   1.40 ~~23~~ 92
   35.45 ~~585~~ then from edge marsh 34.05 run along edge 2340

7	S 42 E	2.27	37	150
8	S 59 E	2.78	46	183
9	S 10¾ E	3.40	56	224
10	S 42¼ W	4.05 (4.05)	67	267
11	S 4¾ E	2.53	42	167
12	S 11¼ E	8.05	133	531
13	S 62¾ E	1.05	17	69 (½ same station N 66¾ E 3.08) 203'
14	N 1¼ W	8.55	141	564
15	N 42¼ E	2.50	41	165
16	N 49 E	6.72 (6.72)	111	444
17	East	10.95	181	723
18	S ½ W	4.70	78	310

19. S 54¼ E 80 .80 — ~~13~~ 53'

20. S 23¾ W 4.40 ~~23~~ 290

21. S 5½ W 2.90 ~~48~~ 191

22. N 50¼ E ~~2.33~~ 2.43 ~~40~~ 160 ~~to small cedar on ditch bank. Sa. Co.~~ .10 -7'

to cen. ditch on side line. Then go to starting point at Mulberry stump and run

N 8½ E 19.85 ~~328~~ 1310 to turn in ditch at marsh

N 3½ E 8.97 ~~148~~ 592 to " " "

N 10¾ E 2.40 ~~40~~ 158 to mouth of gut .35 -23' Rt.

N 19 W 3.50 ~~58~~ 231 } 294 edge Crk .70 -46' right

" .95 ~~16~~ 63 " " .50 -33' "

N 72¾ W 1.50 ~~25~~ 99 } 172 " .25 -17' " (next page)

" 1.11 ~~18~~ 73 " .85 -56 "

then run out point of Marsh

N 14E .75 50' crk .25 -17' Right & lft

" 1.00 66 116 " .70 -46' " " "

" 1.25 82 198 116 314

from here run following for point of marsh

S 57½ E 1.52 ~~25~~ 100

S 85¼ E 2.10 ~~35~~ 139

N 71¼ E 2.85 ~~47~~ 188

N 59 E 1.95 ~~32~~ 129

N 22 W 2.90 ~~48~~ 191

N 44¼ W 4.60 ~~76~~ 304

N 83¼ W 3.70 ~~61~~ 244

S 82½ W 1.60 1.60 — ~~26~~ 106 crk .25 (17') lft over rgt

" 1.40 ~~23~~ 92 " .50 (33') "

" 3.40 ~~56~~ 244 edge creek

then Extend Co. N 14E 1.75 (116') to edge crk

Then from end of Co. N 72¾W run

S 73½W	4.42	~~75~~ 292	crk .40 (26') right
N 44½W	2.28	~~38~~ 150	(pine here Plat shows offset for edge crk)
N 60¼W	2.68	~~44~~ 177	
S 8¾W	2.08	~~34~~ 137	
S 59¾E	2.27	~~37~~ 150	
S 11¾W	1.61	~~27~~ 106	
S 72 W	1.39	~~23~~ 92	
S 35½W	1.59	~~26~~ 105	
S 59¼W	6.10	~~101~~ 403	
N 29¾W	2.88	~~48~~ 190	
S 81 W	3.38	~~56~~ 223	
N 13¼W	1.93	~~32~~ 127	
S 77¾W	~~.47~~	~~11~~ 44	up cen. Branch
N 60 W	1.99	~~33~~ 131	to Cent. ditch
S 5¾E	1.24	~~20~~ 82	to stob on marsh line .45 (30') right in ditch

Division line of high land. Start at stob cen. lane at Main Road and run N 79¾E 11.61 ~~192~~ 766 to edge of front porch (line run thro. house)

" .53 ~~9~~ 35 ~~80~~ 81 to back porch

" ~~14~~ ~~231~~ ~~924~~ .14 – ~~2~~ 9 ~~810~~ to stob

N 87¾E 10.75 ~~177~~ 710 to large locust

East 3.21 ~~53~~ 212 along drain to stob

N 1°20'W 4.27 ~~70~~ 282 stob edge grave yard

" 5.59 ~~92~~ ~~369~~ ~~163~~ 651 to stob edge ditch

← was 9.86, recent change

Division of marsh land runs from gum N 22¼E across marsh to Creek

E. A. Semple Co. Surveyor

4 pole chain